


SRG Global Aerial/Topographic As-Built Survey Morehead, Kentucky

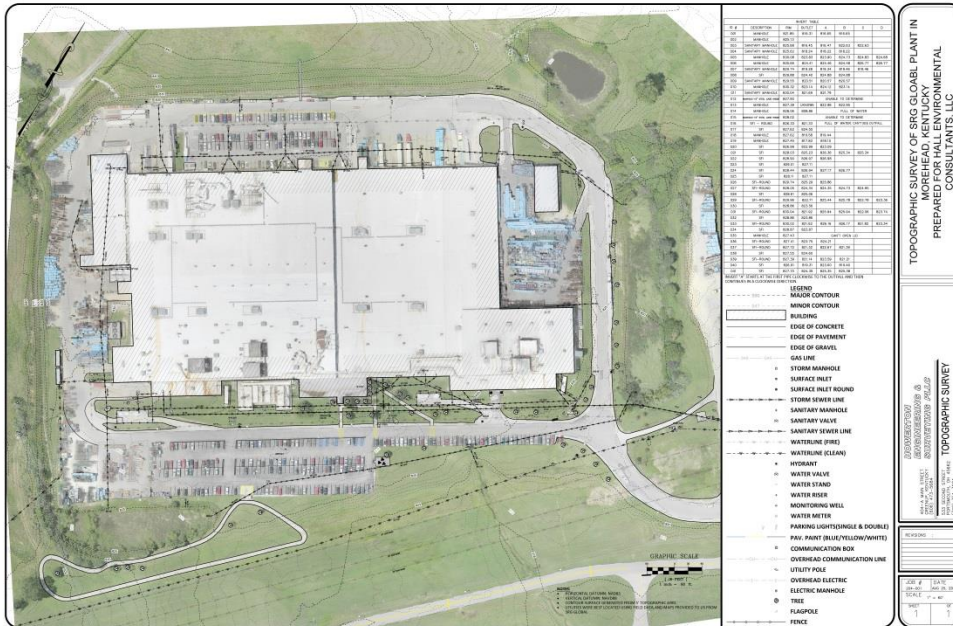

Client/Location

Hall Environmental
Consultants
1376 Danville Rd.
Loop #1
Nicholasville, KY 40356

Client Reference

Jeff Peck, PE
Hall Env.
(859) 885 – 3331
jpeck@hallenvironmental.net

Project Status

Complete

Dates of Service

2015


Special Features

- Plan/Profile
- Topographic Survey
- Drone Orthos
- Aerial Survey
- Aerial Photography Overlay

Project Description

Howerton Engineering & Surveying was contracted by Hall Environmental Consultants, LLC to perform a site survey of the SRG Global Plant located in Morehead Kentucky.

Howerton Engineering & Surveying performed an Aerial survey of the facility along with GPS topographic survey. The existing storm sewer infrastructure was mapped and Hall Env. was presented with a full set of plan/profiles of the facility; along with CAD dwg files.

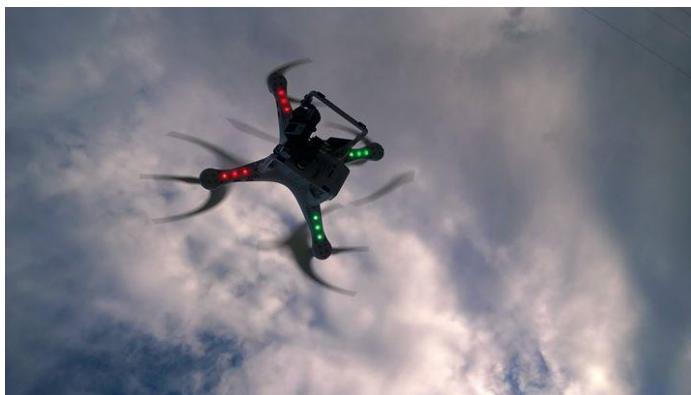

**HOWERTON
ENGINEERING &
SURVEYING PLLC**